



Figure 1 shows a number line from 0 to 500. The line has major tick marks every 50 units, labeled 0, 50, 100, 150, 200, 250, 300, 350, 400, 450, and 500. Several points are marked on the line with arrows pointing to them from labels: 175 is marked between 100 and 200; 2625 is marked between 200 and 300; 375 is marked between 300 and 400; 500 is marked at the 500 tick mark; 1875 is marked between 150 and 200; 3100 is marked between 300 and 350; 500 is marked at the 500 tick mark; 2750 is marked between 250 and 300; 4375 is marked between 400 and 450; and 500 is marked at the 500 tick mark.

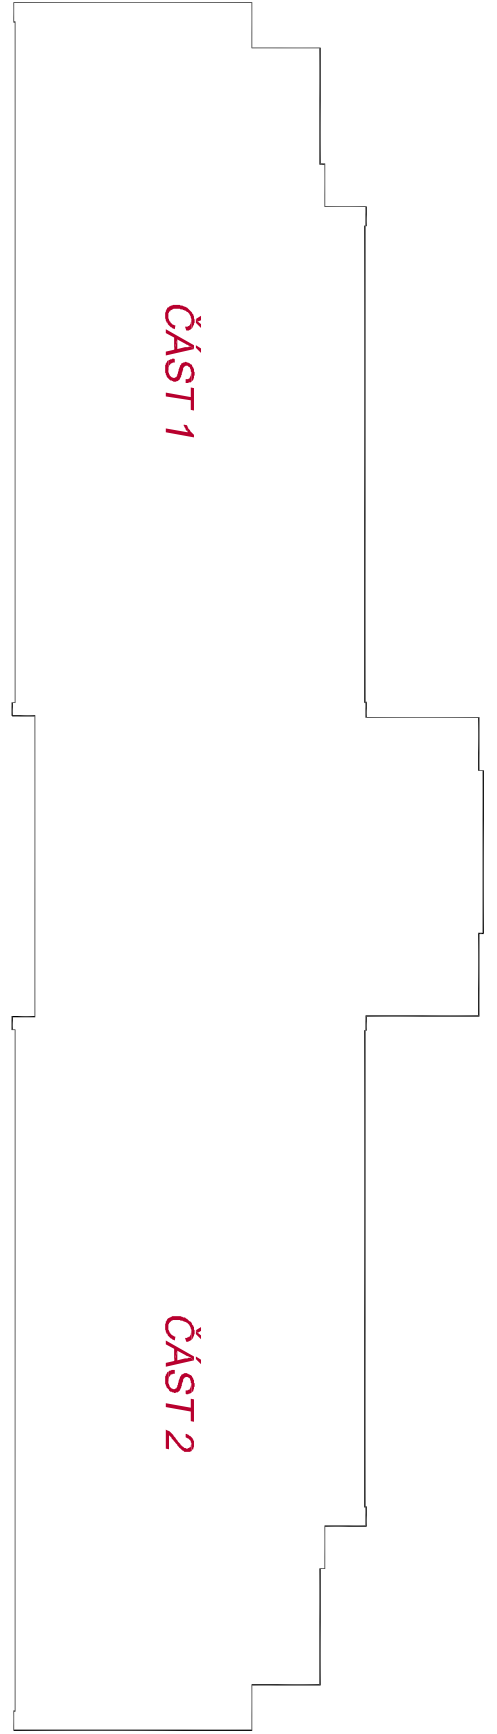


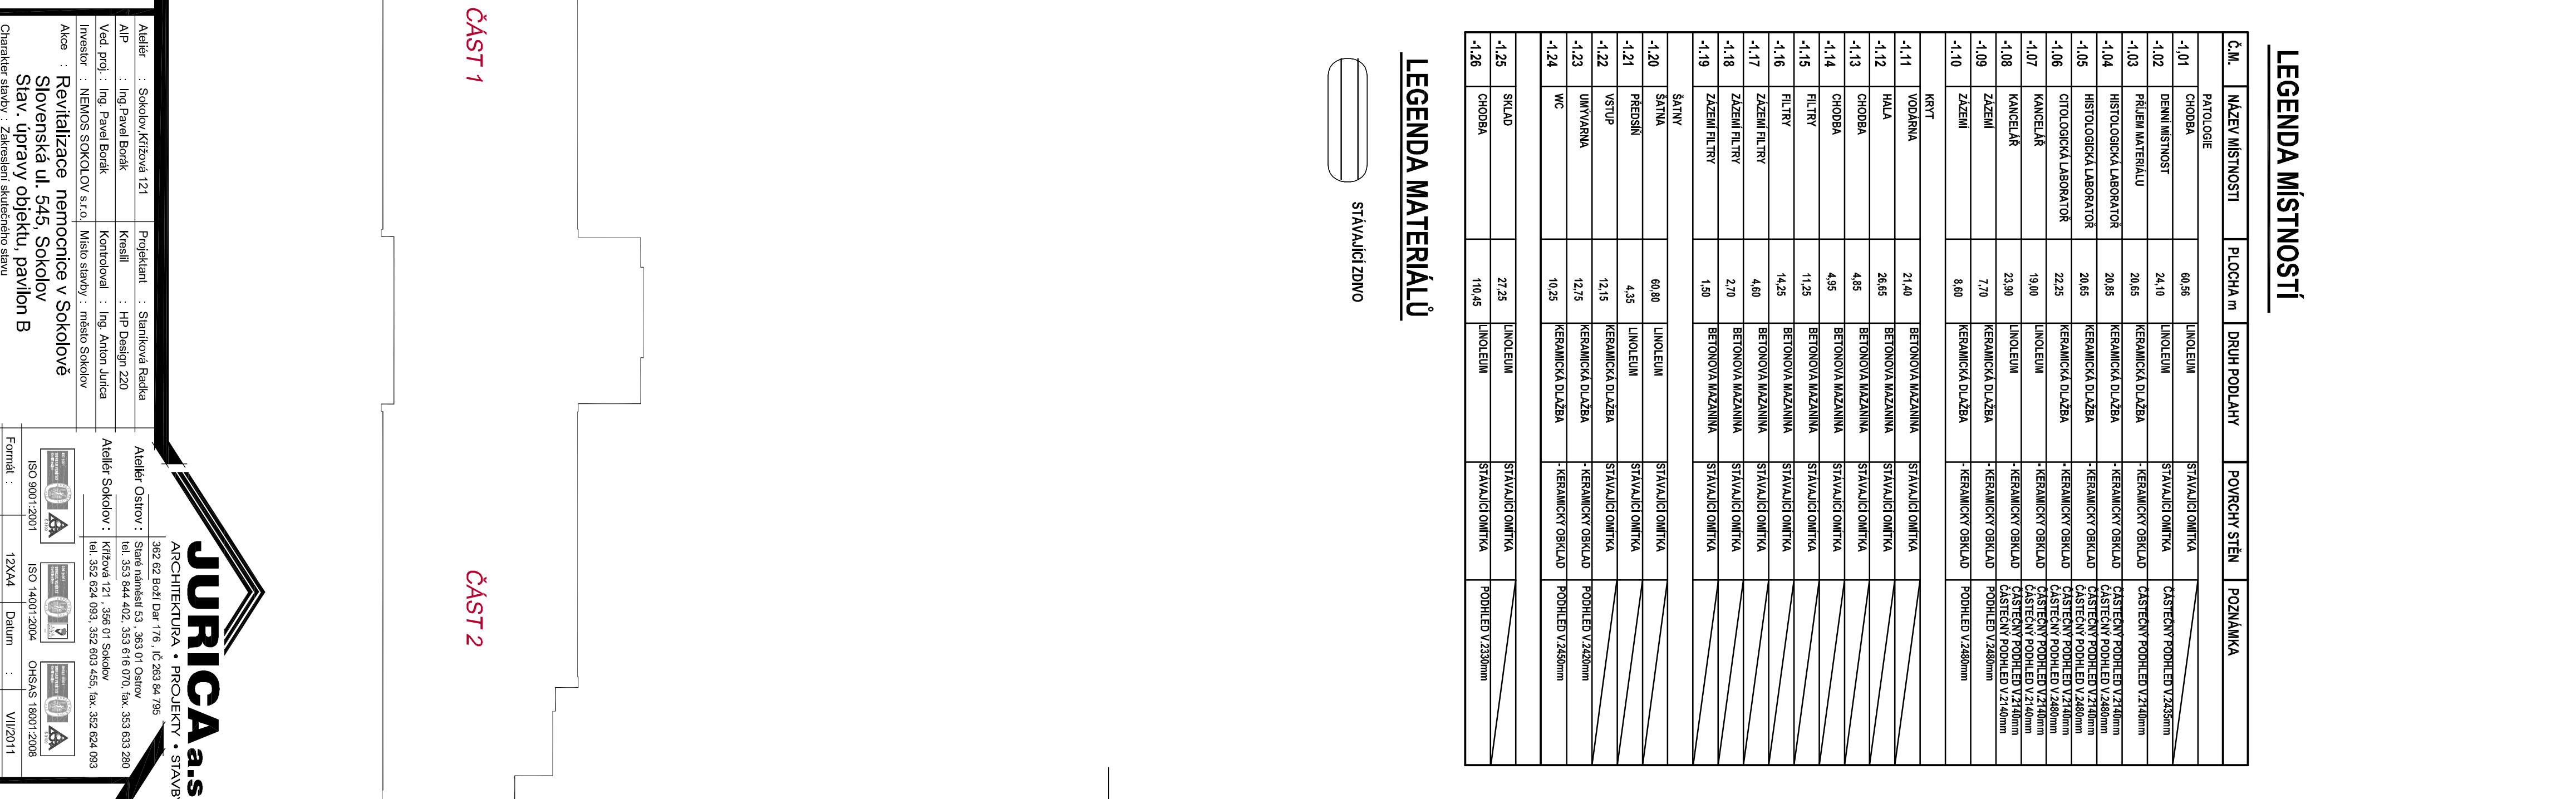

**SPOJOVACÍ KORIDOR**

[illegible]

## LEGENDA MATERIALŪ

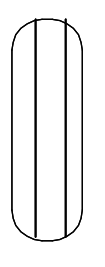

STÁVAJÍCÍ ZONOVÁ